

PLEASE POST

Planning Commissioners
Kaleb Westfall, Seat A
Jason Lamson, Seat B
Gregg Marxmiller, Seat C



William Corbett, Seat D
Andy Anderson, Seat E
Jessica Denslinger, Seat F
Elizabeth Clark, Seat G

**DILLINGHAM PLANNING COMMISSION
REGULAR MEETING**

June 12, 2019 **5:30 p.m.**
Teleconference Line: 1-800-791-2345 **Passcode: 28135**

Agenda

- 1. CALL TO ORDER**
- 2. ROLL CALL**
- 3. APPROVAL OF MINUTES**
- 4. APPROVAL OF AGENDA**
- 5. COMMUNICATIONS**
 - a. Communications to the planning commission
 - b. Planner's report
 - c. Citizen's comments on items not on the agenda
- 6. PUBLIC HEARINGS**
- 7. UNFINISHED BUSINESS**
- 8. NEW BUSINESS**
 - a. Long-Term Encroachment Permit – Nushagak Cooperative
- 9. CITIZEN COMMENTS**
- 10. COMMISSIONER COMMENTS**
- 11. ADJOURNMENT**
 - a. Planning Commission Meeting July/August TBD 5:30 PM



Encroachment Permit Application
 City of Dillingham
 PO Box 889, Dillingham, Alaska 99576

Application received: ____/____/____ Fee Paid \$: Please Invoice \$75.00

Applicant Name: William Chaney

Phone Number: 907-842-5251

Owner's Name: Nushagak Cooperative

Mailing Address: P.O. Box 350

City, State, Zip Code: Dillingham, Alaska 99576

Phone Number: 907-842-5251 Fax: 907-842-2790

Email: wchaney@nushagak.coop

Property Location/Description: Waskey Road @ pole W30-7, digging across Waskey road @ 40" to run the conduits across. road will remain passable during installation

Basis for encroachment permit request: Connect the Waskey Road remote to the Fiber optic network

Other special conditions: _____

Short Term Permit Long Term Permit Period requested: from 6 / 6 / 2019 to 12 / 31 / 2119

Provide all requested information above and attach appropriate as-built survey. You must include the \$75.00 non-refundable encroachment permit fee with your application to be processed.


Information included in this permit application is, to the best of my knowledge, true and complete. I acknowledge and will comply with the requirements set forth by this encroachment permit. I acknowledge that this permit does not grant approval to any other federal, state, or city permits that may be required.

Applicant's signature: *William Chaney* Date: 6-6-19

Landowner's signature: _____ Date: _____

To Be Completed By City:

_____	_____
City Manager	Date
_____	_____
Planning Director	Date
_____	_____
Public Works Director	Date
Action Taken by City: <input type="checkbox"/> Approved <input type="checkbox"/> Denied <input type="checkbox"/> Incomplete, return to applicant	

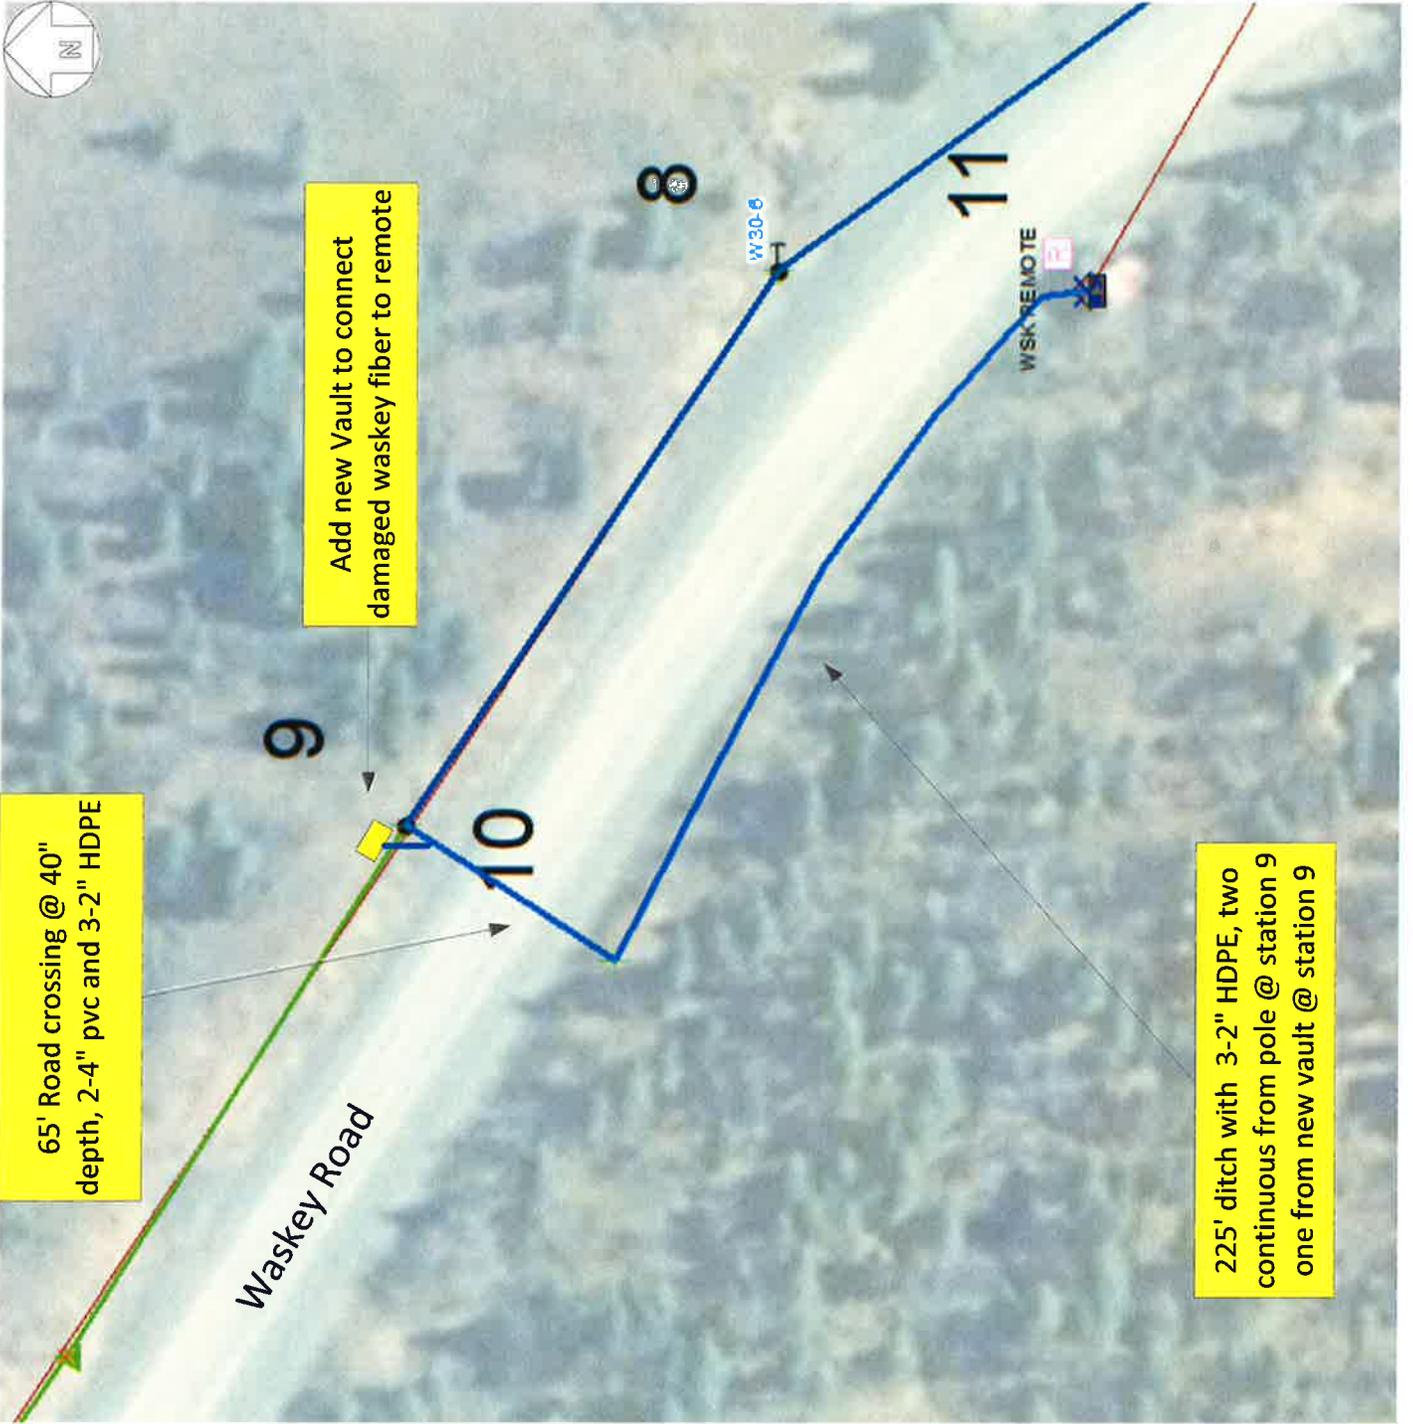

Add new Vault to connect damaged waskey fiber to remote

65' Road crossing @ 40" depth, 2-4" pvc and 3-2" HDPE

225' ditch with 3-2" HDPE, two continuous from pole @ station 9 one from new vault @ station 9

key