# DILLINGHAM FIRE STATION

**PROJECT NUMBER** 84035

## ARCHITECT
# PAUL D. SELBERG A.I.A.

## STRUCTURAL
GRAND/KENLEY, INC.

## MECHANICAL
GENESIS ENGRS.

## ELECTRICAL
ARCTIC CONSULTING ENGRS.

## INDEX TO DRAWINGS


| | |
|---|---|
| C-1 | SITE PLAN |
| A-1 | FLOOR PLAN |
| A-2 | ELEVATION, UPPER LEVEL FLOOR PLAN |
| A-3 | BUILDING ELEVATIONS |
| A-4 | SECTION |
| A-5 | WALL SECTIONS, DETAILS |
| A-6 | SECTIONS |
| A-7 | ROOM FINISH, DOOR, WINDOW SCHEDULES, DETAILS |
| S-1 | GENERAL NOTES, TYPICAL DETAILS |
| S-2 | FOUNDATION PLAN & DETAILS |
| S-3 | ROOF FRAMING PLAN & DETAILS |
| M-1 | MECHANICAL FLOOR PLANS |
| M-2 | MECHANICAL DETAILS |
| M-3 | MECHANICAL NOTES & DETAILS |
| E-1 | FLOOR PLAN, LIGHTING & POWER |
| E-2 | LEGEND & DIAGRAMS |


RECORD SET 3/21/85

project title:


SELBERG ASSOCIATES INC.
p.o. box 872708
wasilla, alaska
99687
907-376-4999


project no.:

date:

drawn by:

revised:

sheet title:

sheet no:

of

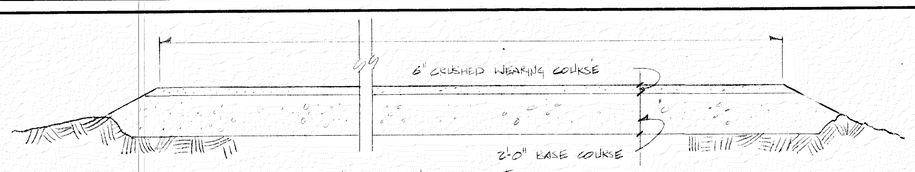


EXCAVATE AS REQ'D & COMPACT TOP 6" OF SUBGRADE TO 95%

GRADATION SPECIFICATIONS

| | SIEVE | % PASSING |
|---|---|---|
| BASE COURSE | 4" | 100 |
| | 2" | 85-100 |
| | No. 4 | 30-70 |
| | No. 200 | 0-10 |

| SIEVE | % PASSING |
|---|---|
| 1" | 100 |
| No 4 | 40-75 |
| No 10 | 25-55 |
| No 200 | 4-10 |

WEARING COURSE: 50% OF PARTICLES RETAINED ON #4 SIEVE

CROSS - SECTION B-B (TYPICAL)

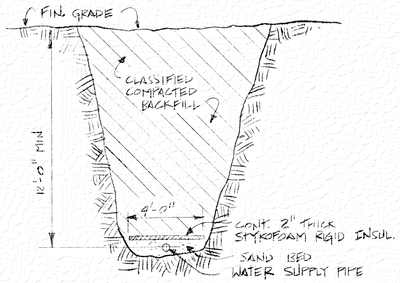


SECTION C-C

1/4" = 1'-0"

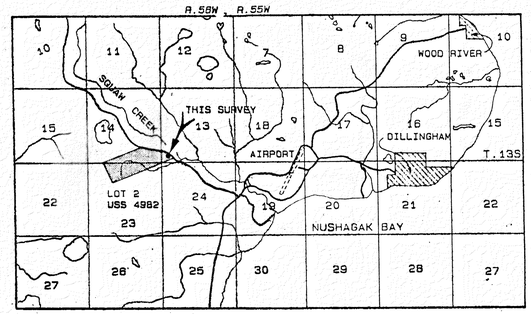


AREA MAP

SCALE: 1" = 1 mile

DILLINGHAM (A-7) QUADRANGLE





1" = 1'-0"

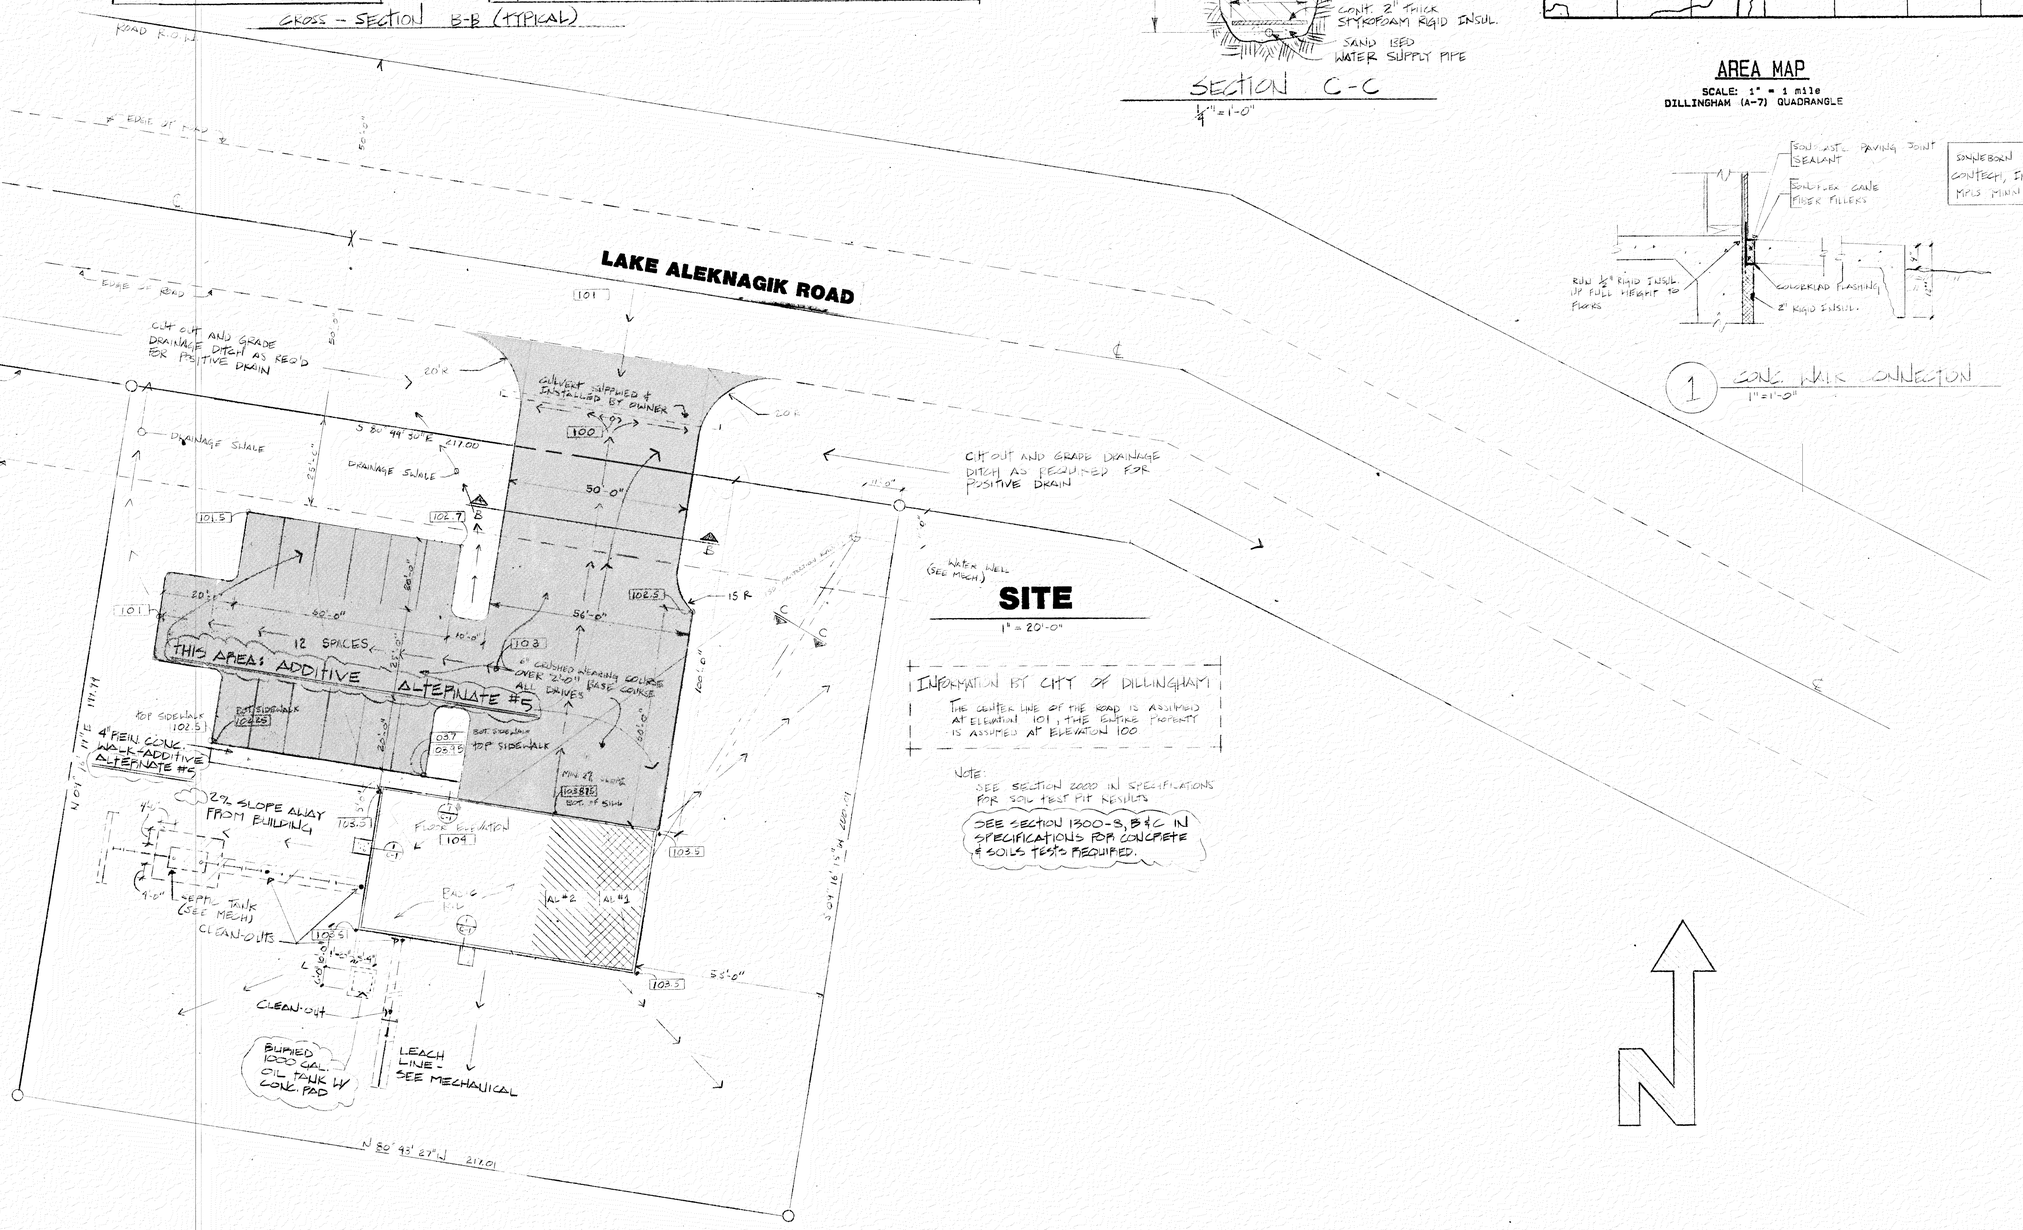


SITE

1" = 20'-0"

INFORMATION BY CITY OF DILLINGHAM

THE CENTER LINE OF THE ROAD IS ASSUMED AT ELEVATION 101, THE ENTIRE PROPERTY IS ASSUMED AT ELEVATION 100

NOTE:

SEE SECTION 2000 IN SPECIFICATIONS FOR SOIL TEST PIT RESULTS

SEE SECTION 1300-B, B&C IN SPECIFICATIONS FOR CONCRETE & SOILS TESTS REQUIRED.

REVISIONS 1-30-85

project title: DILLINGHAM FIRE STATION


SELBERG ASSOCIATES INC.

p.o. box 872708
wasilla, alaska
99687
907-376-4999


project no.: 84035

date: 7-17-84

drawn by: W.H.S.

revised: 1-30-85

sheet title: SITE PLAN

sheet no: C-1

of